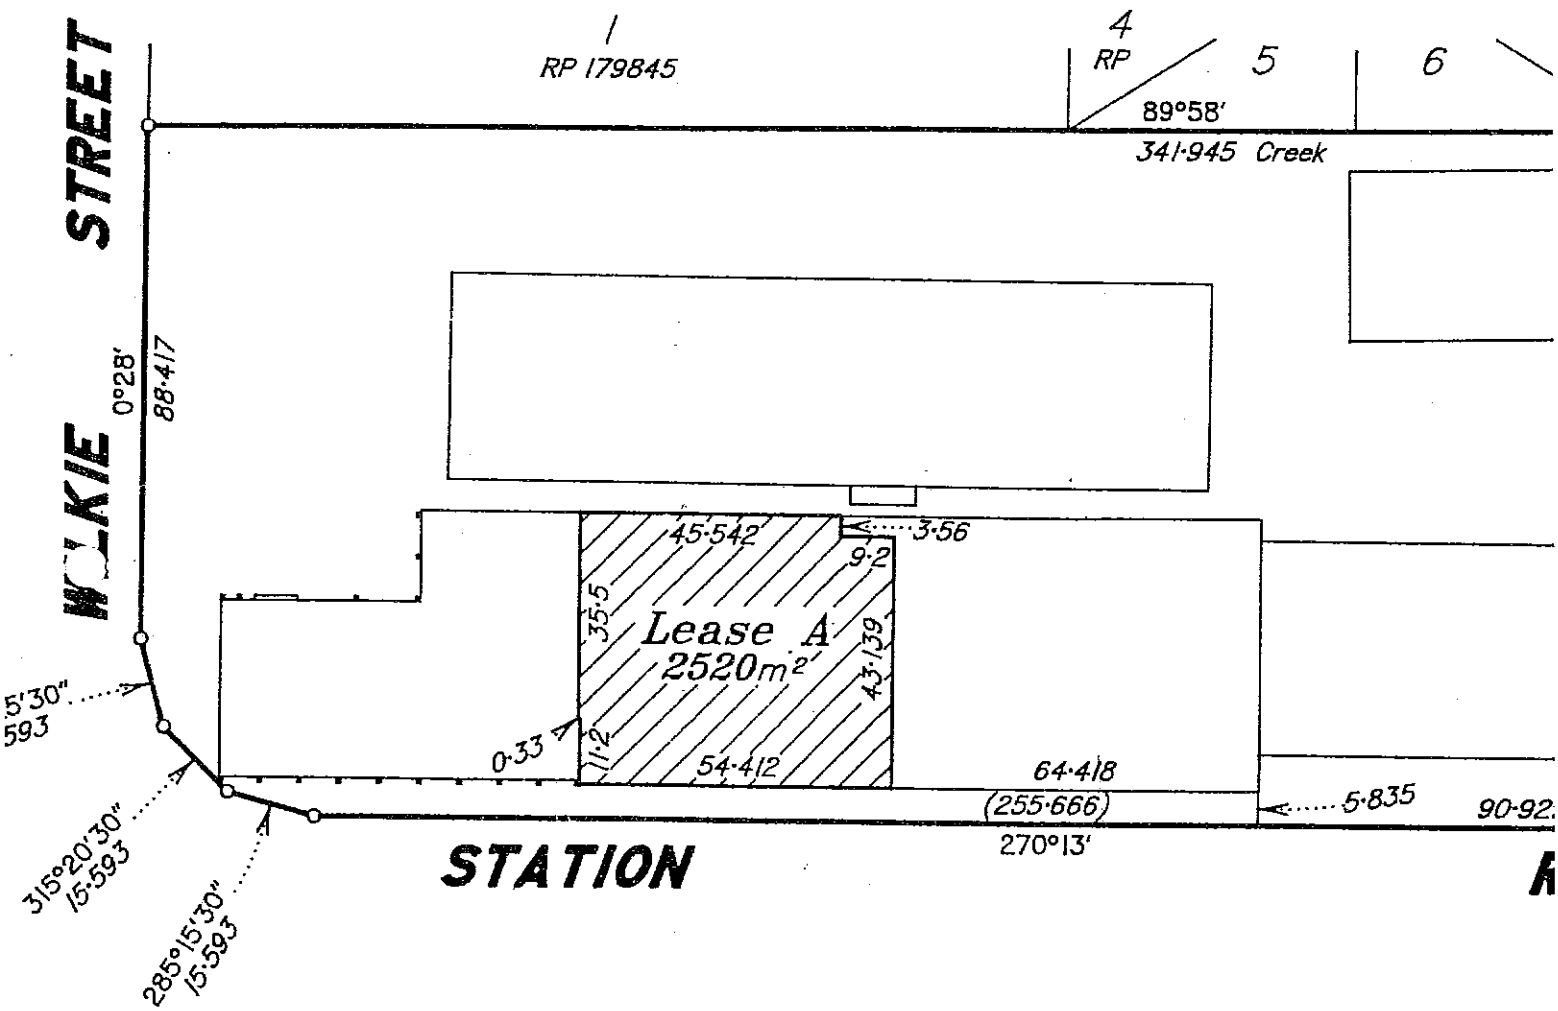
1
RP 179845
4
RP
5
6
89°58'
341·945 Creek
STREET
0°28'
88·417
45·542
3·56
9·2
35·5
Lease A
2520m²
43·139
0·33
11·2
54·412
64·418
(255·666)
5·835
270°13'
STATION
315°20'30"
15·593
285°15'30"
15·593

COPY

N

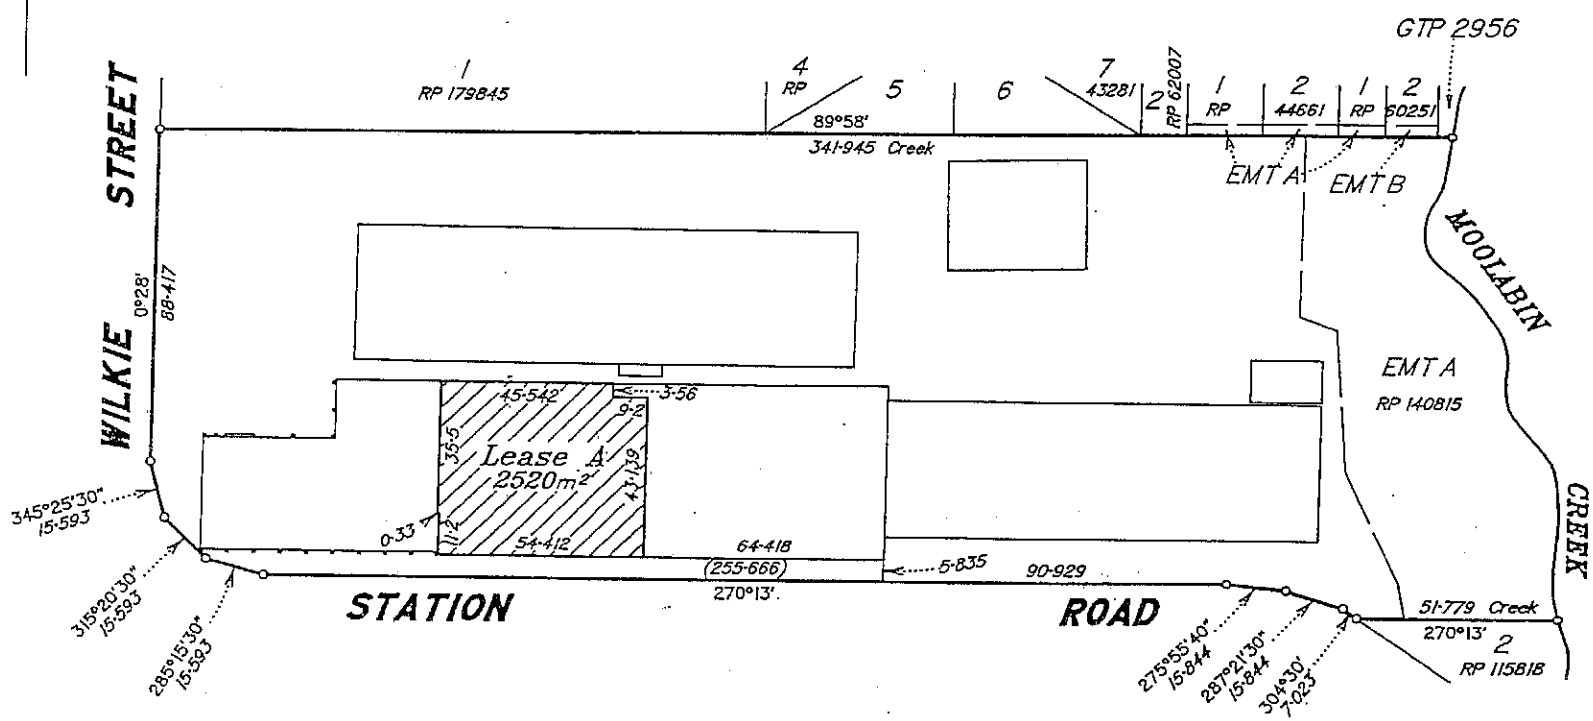

0 10 20 30 40 50 60 70 80 90 100 110m

SCALE 1:1500

NOTE:

~~1. AREAS AND DIMENSIONS ARE APPROXIMATE ONLY AND ARE SUBJECT TO FIELD SURVEY.~~

~~2. CONTOURS ARE DERIVED FROM~~

LEASE EXTENDS TO EXTERNAL FACE OF OUTSIDE WALLS AND CENTRELINE OF INTERTENANCY WALLS.

CLIENT:

SHILLINGTON INVESTMENTS PTY. LTD

PROJECT:

PLAN OF LEASE ~~A~~ OF PART OF the ground floor of a ~~A~~ BUILDING ON LOT 1 ON RP 115818 CT REF 18195037

LOCAL AUTHORITY:

BRISBANE CITY COUNCIL

DATE 6-6-95	SURVEYED
SCALE 1:1500	DRAWN P.REDFORD
FB NO	CHECKED
LEVEL DATUM	

ROY SOMERVILLE SURVEYS PTY. LTD. ACN 010 971 383 hereby certify that the details shown on this sketch plan are correct.

THE COMMON SEAL OF Richard Thomas HUME Registered Surveyor

Michael Edward LONG Director

Date 8/6/95

ROY SOMERVILLE SURVEYS PTY. LTD. ★ 010 971 383

ROY SOMERVILLE SURVEYS PTY LTD
A.C.N. 010 971 383
LICENSED SURVEYORS and DEVELOPMENT CONSULTANTS
PHONE: 07-808 1791
P.O. Box 1198 SPRINGWOOD 4127

DRAWING NO: 2015-01

Gyrboro Plan 1

54.412
× 467
= 2541

9.2
3.56
32.75.

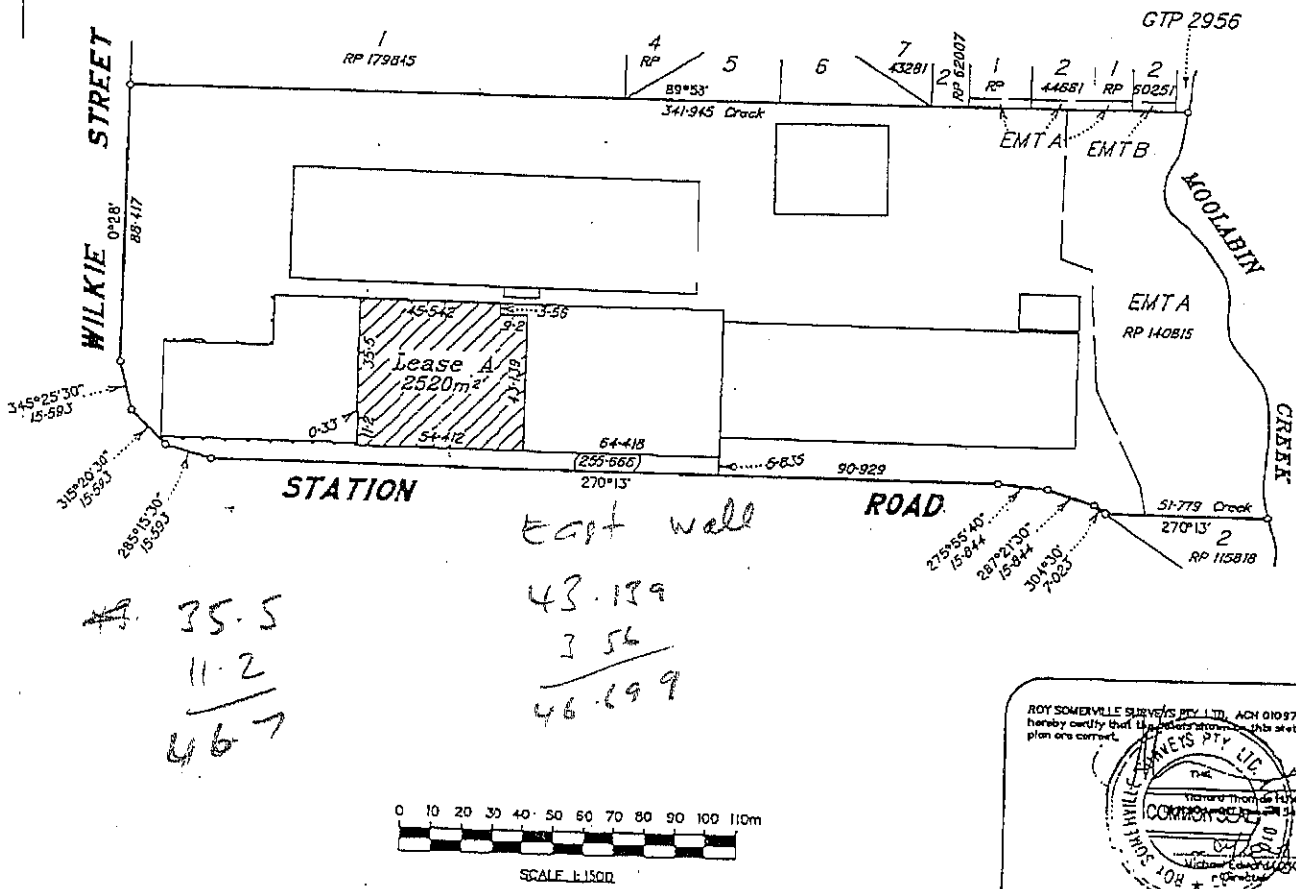

East well
43.199
3.56
46.199

~~4~~ 35.5
11.2
467

46.699
46.270
-4.29.

NOTE:
~~1. AREAS AND DIMENSIONS ARE APPROXIMATE ONLY AND ARE SUBJECT TO FIELD SURVEY.~~
~~2. CONTOURS ARE DERIVED FROM~~
LEASE EXTENDS TO EXTERNAL FACE OF OUTSIDE WALLS AND CENTRELINE OF INTERTENANCY WALLS.

CLIENT:
SHILLINGTON INVESTMENTS PTY LTD

PROJECT:
PLAN OF LEASE ~~A~~ OF PART OF ~~A~~ BUILDING ON LOT 1 ON RP 115818 CT REF 18195037

LOCAL AUTHORITY:
BRISBANE CITY COUNCIL

DATE 6-6-95	SURVEYED
SCALE 1:1500	DRAWN P.REDFORD
FILE NO	CHECKED
LEVEL DATUM	

ROY SOMERVILLE SURVEYS PTY LTD, ACN 010 971 363 hereby certify that the details shown on this sketch plan are correct.

ROY SOMERVILLE SURVEYS PTY LTD
A.C.N. 010 971 363
LICENSED SURVEYORS and DEVELOPMENT CONSULTANTS
PHONE: 07-608 1791
P.O. Box 1198 SPRINGWOOD 4127

DRAWING NO: 2015-01

Garboro. #15